




SHEET M101 KEYED NOTES	
TAG	NOTE CONTENTS
1	MOUNT UNIT MAXIMUM 11'-0" A.F.F. ROUTE CONDENSATE TO MOP SINK. ROUTE REFRIGERANT LINES TO OUTDOOR CONDENSING UNIT (OU-1).
2	REMOTE TEMPERATURE SENSOR WITH SMALL LOCKABLE OPAQUE VANDERL PROOF COVER.
3	REFER TO ARCHITECTURAL ELEVATIONS FOR LOCATION OF BRICK VENT. OFFSET AND CONNECT DUCT AS REQUIRED FOR VENT LOCATION.
4	36 X 18 X 12 PLENUM. CONNECT FAN DISCHARGE TO PLENUM. CONNECT PLENUM TO ARCHITECTURAL LOUVER.
5	FURNISH LINE VOLTAGE HUMIDISTAT TO ENERGIZE UNDER FLOOR PLAN, 2/M101 THIS SHEET, FOR CRAWL SPACE VENTILATION.
6	IF ALTERNATE IS NOT ACCEPTED DELETE ALL DUCT, AIR DEVICES, CONTROLS, ETC. INCLUSIVE OF AHU-4 AND CU-4.
7	LOCATE THERMOSTATS FOR AHU-1A 1B & AHU-5 AT THIS LOCATION. REFER TO PLAN FOR REMOTE SENSOR LOCATION.
8	LOCATE THERMOSTATS FOR AHU-2,3,4 & 6 AT THIS APPROXIMATE LOCATION. REFER TO PLAN FOR REMOTE SENSOR LOCATION.
9	TYPICAL MOTORIZED OUTSIDE AIR DAMPER AT ALL AHU'S.
10	40 X 24 X 24 OUTSIDE AIR PLENUM CONNECT TO ARCHITECTURAL LOUVER.
11	ROUTE REFRIGERANT PIPING FROM CONDENSING UNIT TO RESPECTIVE AIR HANDLING UNIT. SIZE REFRIGERANT LINES PER MANUFACTURER'S REQUIREMENTS. REFER TO DETAIL.
12	ROUTE CONDENSATE DRAINS FROM UNITS TO FLOOR DRAIN. ROUTE TO AVOID TRIP HAZARD.
13	REFER TO ARCHITECTURAL RETURN AIR FEATURE AT THIS LOCATION.
14	RETURN AIR FILTER PULL. (TYPICAL)
15	

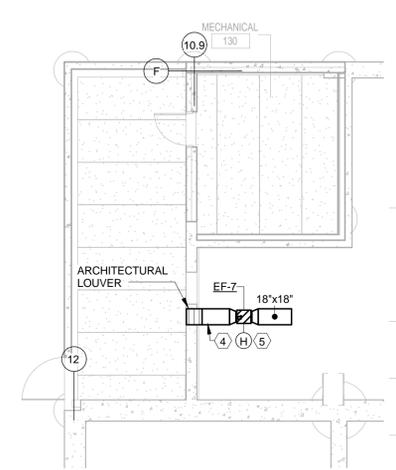


2 PARTIAL UNDERFLOOR PLAN
1/8" = 1'-0"

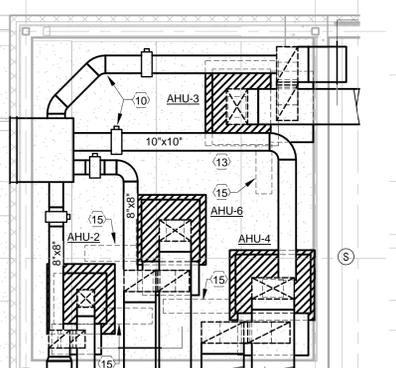

3 ENLARGED MECH. ROOM 130 - HVAC
1/4" = 1'-0"

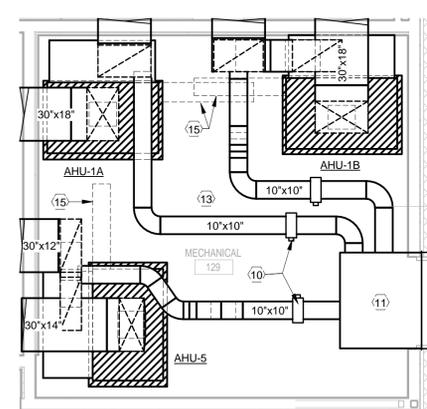

4 ENLARGED MECH. ROOM 128 - HVAC
1/4" = 1'-0"

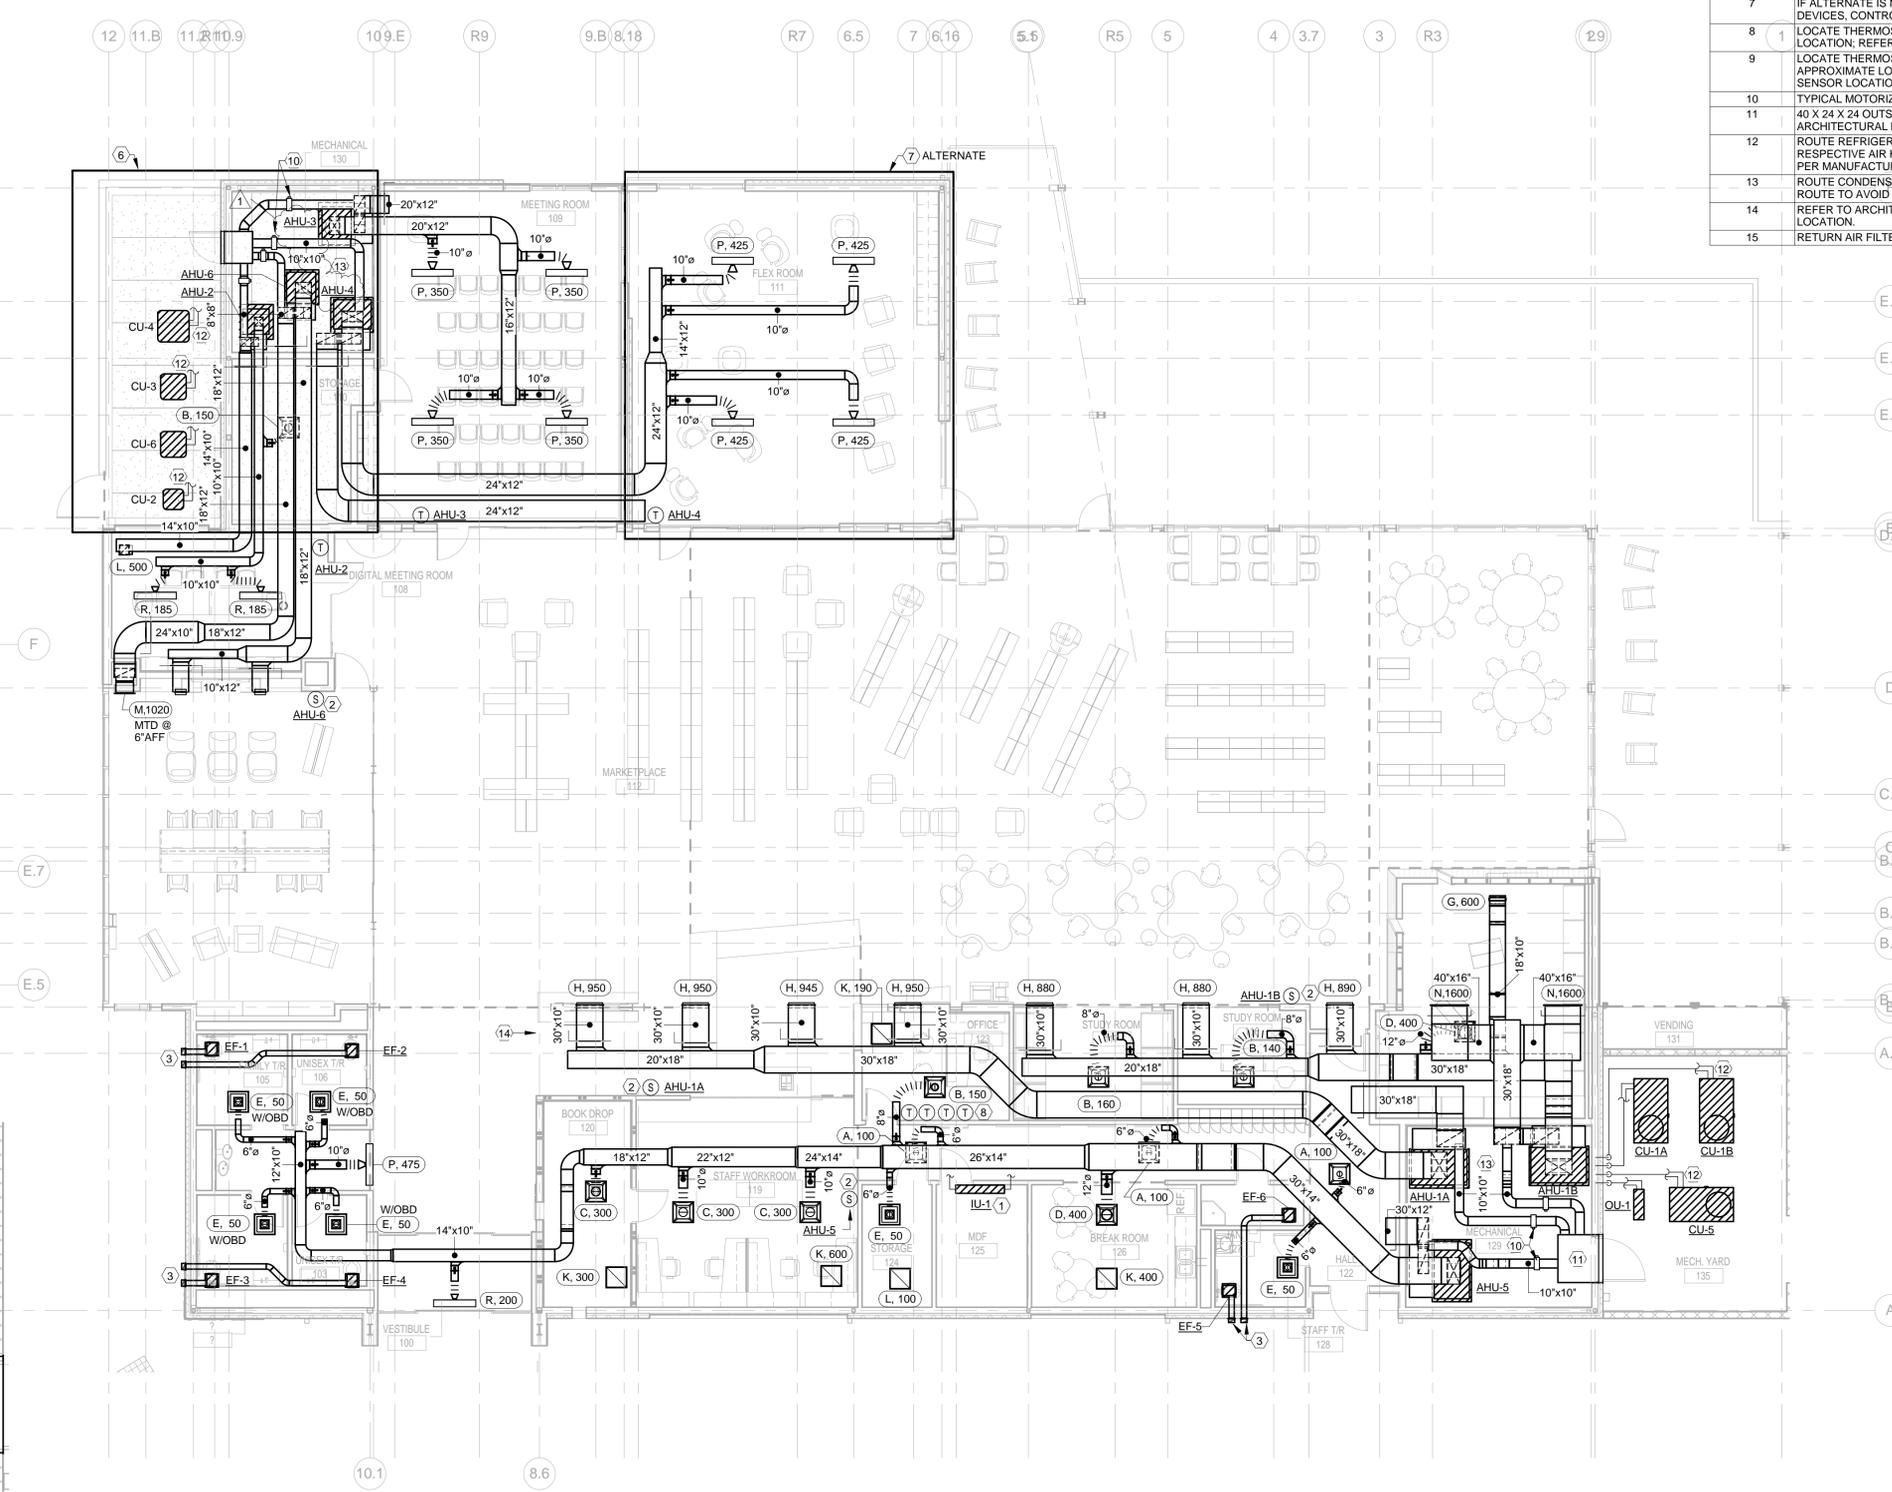

1 LEVEL 1 - FLOOR PLAN - HVAC
1/8" = 1'-0"

COOLPA
 L. 210.829.730
 E. lpa@coolpa.com
 P. 210.829.737
 W. www.coolpa.com
 114 East Cavallins Street
 San Antonio, Texas 78224

H2MG
 70 W. Loop West, Suite 400, San Antonio, TX 78215
 San Antonio, Texas 78216
 Tel: 210.525.0225
 Texas Firm Registration #F-12083
 Copyright © 2014

DISTRICT 2 BRANCH
 LIBRARY
 U.S. HWY 87, SAN ANTONIO,
 TEXAS 78222
 Developed for
 CITY OF SAN ANTONIO

THIS DOCUMENT IS THE PROPERTY OF H2MG ENGINEERING, P.C. IT IS TO BE USED ONLY FOR THE PROJECT AND SITE SPECIFICALLY IDENTIFIED HEREIN. ANY REUSE OR MODIFICATION OF THIS DOCUMENT WITHOUT THE WRITTEN CONSENT OF H2MG ENGINEERING, P.C. IS STRICTLY PROHIBITED. H2MG ENGINEERING, P.C. SHALL NOT BE RESPONSIBLE FOR ANY ERRORS OR OMISSIONS IN THIS DOCUMENT. THE USER ASSUMES ALL LIABILITY FOR THE ACCURACY AND COMPLETENESS OF THE INFORMATION CONTAINED HEREIN. H2MG ENGINEERING, P.C. IS NOT PROVIDING CONTRACT ADMINISTRATION SERVICES. THIS DOCUMENT IS NOT TO BE USED FOR ANY OTHER PROJECT OR SITE WITHOUT THE WRITTEN CONSENT OF H2MG ENGINEERING, P.C.

Revision	Date
1 ADDENDUM 1	11-7-14

Job No. 12021
 Date OCTOBER 17, 2014
 Checked by BR
 Scale As indicated

LEVEL 1 - FLOOR
 PLAN HVAC



District 2 Library

Addendum #1 Landscape & Irrigation Narrative

- TP1.0 Proposed Trees located to the North of the building (1 Cedar Elm & 2 Red Oaks) have been relocated to the South and Southeast of the building.
- LP1.0 Proposed Trees located to the North of the building (1 Cedar Elm & 2 Red Oaks) have been relocated to the South and Southeast of the building. Pavers spacing has been increased and now extend to the Adult Porch. The number of pavers has not changed, only the spacing.
- LP1.2 Pavers spacing has been increased and now extend to the Adult Porch. The number of pavers has not changed, only the spacing.
- LP3.1 Pavers spacing was 1” and has been increased to 2” with random intervals of 4” spacing between pavers. The number of pavers has not changed, only the spacing.
- IR1.1 Irrigation Controller & Weather Station relocated to South Mechanical Yard.
- IR1.2 6 Tree Bubblers to the North of the Building have been relocated for 3 new proposed tree locations to the Southeast of the Building.

LANDSCAPE ORDINANCE

Parking-lot Shading Calculations				2/21/2014	
Project					
Total Parking-lot Area=	19,930.00 sf				
Shade Coverage Required=	25%				
Shade Coverage Provided=	4,982.50 sf				
Key # of Trees Shade Value					
See Plan Large trees					
A	0	1200	@ 100%	0.00 sf	Bald Cypress, Cottonwood, Deodar Cedar, Pecan, Red Oak, Sycamore, Burr Oak and Texas Sycamore
B	13	1200	@ 75%	11,700.00 sf	
C	0	1200	@ 50%	0.00 sf	
Medium/Large trees					
D	0	875	@ 100%	0.00 sf	Anaqua, Arizona Cypress, Live Oak, Texas Grn Ash, Blk Willow, Cedar
E	0	875	@ 75%	0.00 sf	Elm, Chinkapin Oak, Esc. Blk. Cherry,
F	0	875	@ 50%	0.00 sf	Ash Juniper, Hackberry, Eve's Necklace, and Western Soapberry
Medium trees					
G	0	550	@ 100%	0.00 sf	Honey Locust, Huisache & Lacey Oak
H	0	550	@ 75%	0.00 sf	
I	0	550	@ 50%	0.00 sf	
Medium/Small trees					
J	0	275	@ 100%	0.00 sf	Anacacho Orchid Tree, Ashe Juniper, Carolina Buckthorne, Yaupon, Condalia,
K	0	275	@ 75%	0.00 sf	Condalia, Crabapple, Goldenball Lead
L	0	275	@ 50%	0.00 sf	Tree, Mesquite, Persimmon, Possumhaw, Redbud, Retama, Wild Olive, and Vitex
Total Shade Coverage Provided= 11,700.00 sf					
Total Shade Coverage Required= 58.71%					
100% shade value for existing trees meeting RPZ criteria					
75% shade value for trees in islands or peninsulas					
50% shade value for trees within 12' of a parking surface					

ELECTIVE REQUIREMENTS - 70 points required

Tree Preservation - 40 points, maximum	Qty.	Points
4 to 6 inch trees	3 points each	-
6 to 12 inch trees	4 points each	6
12 to 18 inch trees	6 points each	9
18 inch trees and larger	8 points each	8
		24
		54
		64

Inside Streetyard:
full credit up to 30 points
1/2 credit for total above 30 points

Outside Streetyard:
1/2 credit up to a maximum of 15 points

Total Points: Tree Preservation (40 Points, max.)

Parking Lot Shading	Points
Percent Shaded	
25%	20
35%	25
50%	35 ✓


Total Points: Parking Lot Shading 35 ✓
Screening of Surface Parking - 25 points
Street Trees - 25 Points
Understory Preservation or Restoration - 15 Pnts.
Infill or Retrofit Use Pattern - 25 pnts.
Total Points - Elective Criteria 75 ✓

Tree Schedule


SYMB	QTY	Common Name	Botanical Name	Container	Size / Spacing / Comments
TREES					
BUO	1	Burr Oak	<i>Quercus macrocarpa</i>	36" box	16'-18" ht, 9'-12" sp., 5" cal., 5'-6' clr. trunk
BC	4	Bald Cypress	<i>Taxodium distichum</i>	30 gal. or 24" box	12'-14" ht, 5'-7" sp., 3"-4" cal., 4'-5' clr. trunk
SYC	12	Mexican Sycamore	<i>Platanus mexicana</i>	24" box	15'-17" ht, 6'-7" sp., 2"-2-1/2" cal., 4'-6' clr. trunk
RO	10	Shumard Red Oak	<i>Quercus shumardii</i>	24" box	12" min. ht, 5'-7" sp., 2-1/2" cal., 3' clr. trunk
CE	14	Cedar Elm	<i>Ulmus crassifolia</i>	24" box	13'-14" ht, 6'-7" sp., 3"-4" cal., 5' clr. trunk
LO	4	Live Oak	<i>Quercus virginiana</i>	24" box	8'-10" ht., 4'-5" sp., 2-1/2-3" cal.
MO	1	Monterrey Oak or Mexican White Oak	<i>Quercus polymorpha</i>	36" box	12'-14" ht., 6'-7" sp., 3-1/2"- 4-1/2" cal., 4'-5' clr. tr
CHO	4	Chinkapin Oak	<i>Quercus muehlenbergii</i>	20" box	9'-10" ht., 3-1/2" - 4-1/2" sp., 2" min. cal.
LYO	6	Lacey Oak	<i>Quercus laceyi</i>	45 gal. or 36" box	2'-5"-3" cal., 14' ht., 6' spread
TLR	8	Thornless Retama	<i>Parkinsonia x 'Desert Museum'</i>	30" box	4'-5" cal., 15' ht., 8' spread (multi-trunk)
TML	2	Texas Mountain Laurel	<i>Sophora secundiflora</i>	30 gal.	5' ht., 4' spread, 1-1/2" cal.

KEY: TREES

LARGE TREES

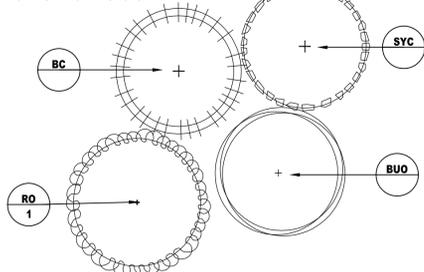


MEDIUM - LARGE TREES

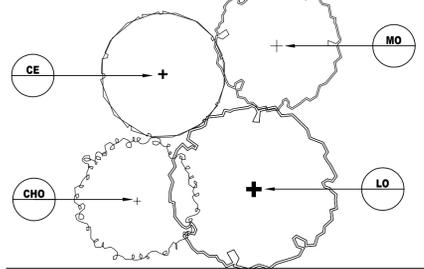

MEDIUM TREES



SMALL - MEDIUM TREES

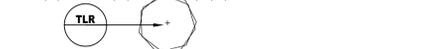


SMALL TREES



PARKING LOT SHADE KEY:

- LARGE TREES**
- A Existing Tree
- B Island or Peninsula Tree within 12 feet of the edge of parking
- C Medium / Large Trees
- D Existing Tree
- E Island or Peninsula Tree within 12 feet of the edge of parking
- F Medium Trees
- G Existing Tree
- H Island or Peninsula Tree within 12 feet of the edge of parking
- I Medium / Small Trees
- J Existing Tree
- K Island or Peninsula Tree within 12 feet of the edge of parking
- L

FOR UNDERSTORY PLANTING, REFER TO SHEET LP1.1 AND SHEET LP1.2

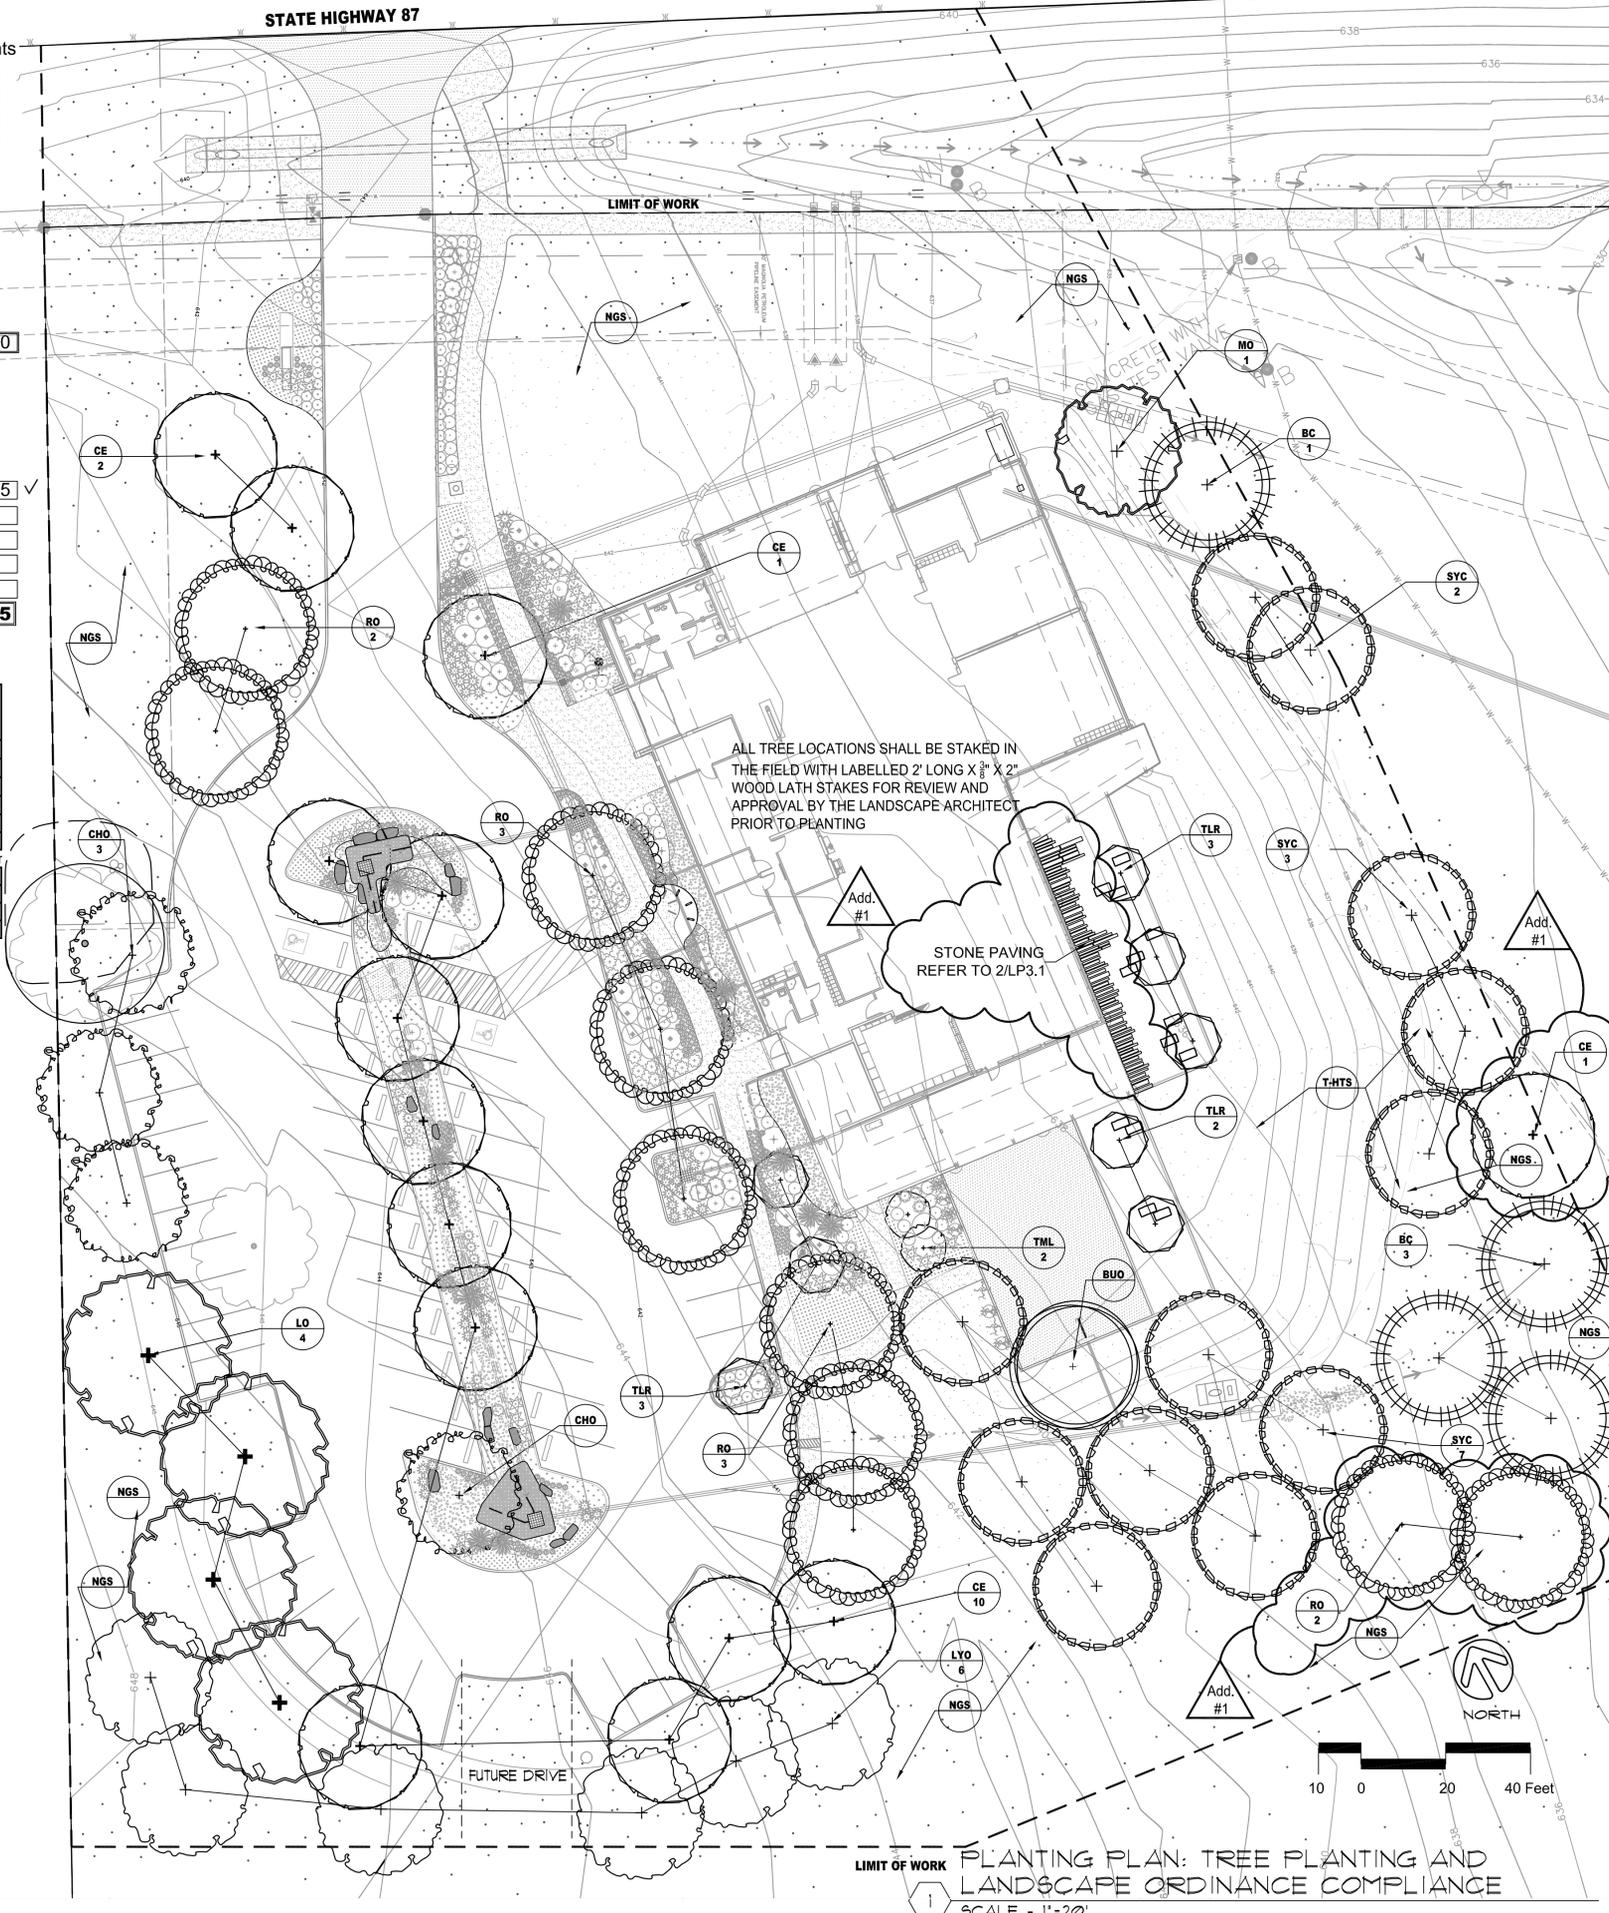

ALL TREE LOCATIONS SHALL BE STAKED IN THE FIELD WITH LABELLED 2" LONG X 3" X 2" WOOD LATH STAKES FOR REVIEW AND APPROVAL BY THE LANDSCAPE ARCHITECT PRIOR TO PLANTING

STONE PAVING REFER TO 2/LP3.1



PLANTING PLAN: TREE PLANTING AND LANDSCAPE ORDINANCE COMPLIANCE
SCALE - 1"=20'

LPA
 LAWRENCE C. CLARK
 LANDSCAPE ARCHITECT
 TX REGISTRATION NO. 1211
 DATE 2014-10-17

BENDER WELLS DESIGN
 Architecture
 Urban Design
 Planning

DISTRICT 2 BRANCH LIBRARY
 U.S. HWY 87, SAN ANTONIO, TEXAS 78222
 Developed for CITY OF SAN ANTONIO

Date	Revision
11/07/14	


Job No.	Project Number
	2014-10-17

Checked by	LCC


Scale	SCALE - 1"=20'

GENERAL NOTES- PLANTING

- A. ALL PLANT QUANTITIES SHOWN ON PLANS ARE TO BE VERIFIED BY THE LANDSCAPE CONTRACTOR. LANDSCAPE CONTRACTOR SHALL BE RESPONSIBLE FOR INSTALLING ALL LABELED PLANT MATERIAL. PLANT QUANTITIES ON THE PLAN TAKE PRECEDENCE OVER QUANTITIES IN THE PLANT SCHEDULE. THE LANDSCAPE CONTRACTOR SHALL NOTIFY THE LANDSCAPE ARCHITECT OF ANY DISCREPANCIES.
- B. LANDSCAPE CONTRACTOR SHALL BE THOROUGHLY FAMILIAR WITH THE PLANS AND SPECIFICATIONS AND SHALL BE RESPONSIBLE FOR THE REQUIREMENTS DICTATED THEREIN.
- C. LANDSCAPE CONTRACTOR AND SUBCONTRACTORS SHALL FAMILIARIZE THEMSELVES WITH THE LOCATION OF ALL UNDERGROUND UTILITIES AND EASEMENTS PRIOR TO STARTING WORK. THE CONTRACTOR SHALL NOTE ANY DISCREPANCIES AND CONTACT THE PROJECT ARCHITECT AND LANDSCAPE ARCHITECT FOR FURTHER DIRECTION.
- D. ALL PLANTS MUST COMPLY WITH THE CURRENT AMERICAN STANDARDS FOR NURSERY STOCK, PUBLISHED BY THE AMERICAN ASSOCIATION OF NURSERYMEN.
- E. NO PLANT SHALL BE PUT IN THE GROUND BEFORE ROUGH GRADING HAS BEEN COMPLETED AND APPROVED BY THE PROJECT LANDSCAPE ARCHITECT OR EQUAL.
- F. ALL PLANTS SHALL BEAR THE SAME RELATIONSHIP TO FINISHED GRADE AS THE PLANT'S ORIGINAL GRADE IN THE CONTAINER OR BEFORE DIGGING.
- G. ALL PLANTS SHALL BE CONTAINER GROWN, UNLESS OTHERWISE NOTED. NO CONTAINER GROWN STOCK WILL BE ACCEPTED IF IT IS ROOT BOUND. ALL ROOT WRAPPING MATERIALS, CONTAINERS, ETC. MADE OF SYNTHETIC MATERIALS OR PLASTICS SHALL BE REMOVED ENTIRELY AT THE TIME OF PLANTING.
- H. ALL CONTAINER GROWN STOCK SHALL BE REMOVED AND THE BALL SHALL BE CUT THROUGH THE SURFACE IN TWO VERTICAL LOCATIONS.
- I. PRIOR TO PLANTING, THE LOCATION OF ALL TREES SHALL BE STAKED IN THE FIELD FOR APPROVAL BY THE LANDSCAPE ARCHITECT, OR HIS REPRESENTATIVE. THE LOCATIONS OF SHRUB MASSES SHALL BE LIKEWISE MARKED IN THE FIELD FOR APPROVAL.
- J. ALL PLANT MATERIALS SHALL BE SELECTED AT THE NURSERIES BY THE LANDSCAPE ARCHITECT, OR HIS REPRESENTATIVE, AND SHALL BE SUBJECT TO INSPECTION AND APPROVAL UPON DELIVERY AT THE PROJECT SITE. SUCH APPROVAL DOES NOT IMPAIR THE RIGHT OF INSPECTION AND REJECTION DURING THE PROCESS OF THE WORK.
- K. ALL PLANTS SHALL BE INSTALLED PER DETAILS AND THE CONTRACT SPECIFICATIONS.
- L. ALL PLANTS ARE TO BE WATERED THOROUGHLY TWICE DURING THE FIRST 24 HOURS AFTER PLANTING.
- M. ALL FINAL GRADING, RAKING AND SHAPING OF THE TOPSOIL, AND BACKFILL OF CURBS AND EDGING SHALL BE APPROVED BY THE LANDSCAPE ARCHITECT PRIOR TO THE APPLICATION OF HYDROSEED OR THE INSTALLATION OF PLANTING.
- N. SLOPES ON BERMS SHALL BE HELD TO 5 : 1 OR LESS, UNLESS OTHERWISE NOTED ON THE CIVIL PLANS. EXCESSIVE SLOPES ON BERMS WHICH MAY RESULT IN EROSION OR MAINTENANCE PROBLEMS SHALL BE REVIEWED BY THE LANDSCAPE ARCHITECT. BERMS SHALL BE INSTALLED IN 12" LIFTS AND COMPACTED TO 90% OF MODIFIED PROCTOR DENSITY AT OPTIMUM MOISTURE CONTENT.
- O. THE LANDSCAPE CONTRACTOR SHALL PROVIDE APPROVED TOPSOIL, BACKFILL MATERIAL, MULCH, SOIL CONDITIONERS AND OTHER AMENDMENTS AS PER THE CONTRACT SPECIFICATIONS.
- P. ALL TOPSOIL, WHETHER NATIVE TO THE SITE OR BROUGHT TO THE SITE, SHALL CONFORM TO THE PROVISIONS OF THE SPECIFICATIONS, WITH RESPECT TO CHEMISTRY AND TEXTURE, PRIOR TO PLACEMENT.
- Q. TOPSOIL SHALL BE PLACED AT A MINIMUM DEPTH OF 4" AT LAWN AREAS AND AT A MINIMUM DEPTH OF 8" IN MASS PLANTED SHRUB AREAS AND CONDITIONED AS DESCRIBED IN THE SPECIFICATIONS. ANY BACKFILL MATERIAL SHALL BE COMPACTED SUFFICIENTLY TO PREVENT EXCESSIVE SETTLING THAT MAY AFFECT FINISHED GRADE OR DRAINAGE.
- R. ALL TOPSOIL FOR TURF SHALL BE RAKED SMOOTH TO GRADE AND RESULT IN A FINISHED GRADE SET AT 1 1/2" BELOW ADJACENT CURB, SIDEWALK OR EDGING AFTER SEEDING. ALL TOPSOIL PLANTING BEDS SHALL BE RAKED SMOOTH AND RESULT IN A FINISHED GRADE SET AT 1 1/2" BELOW ADJACENT CURB, SIDEWALKS, OR EDGING AFTER MULCHING. FINAL GRADES SHALL NOT VARY MORE THAN 1/10 FOOT FROM FINISH ELEVATIONS.
- S. AREAS TO BE SEEDED SHALL BE LOOSENED AND FINE RAKED TO BREAK UP LUMPS AND PRODUCE A SMOOTH EVEN GRADE, FREE FROM UNSIGHTLY VARIATIONS, RIDGES, OR DEPRESSIONS. STONES ONE INCH (1") OR LARGER, STICKS, ROOTS, OR OTHER DEBRIS WHICH MIGHT INTERFERE WITH THE FORMATION OF A FINELY PULVERIZED SEED BED AND EXPOSED DURING THIS OPERATION SHALL BE REMOVED FROM THE SITE. FINE GRADING SHALL BE SUBJECT TO APPROVAL BY THE LANDSCAPE ARCHITECT. AREA SHOWING WEED GROWTH SHALL BE SPRAYED WITH APPROVED POST-EMERGENT SPRAY, MOWED, AND CLIPPINGS REMOVED FROM LAWN AREAS PRIOR TO FINAL GRADING.
- T. ALL BEDS ARE TO BE MULCHED TO A MINIMUM DEPTH OF 4" WITH AN APPROVED MULCH MATERIAL AS SPECIFIED. A SAMPLE OF THE MULCH SHALL BE DELIVERED TO THE LANDSCAPE ARCHITECT FOR APPROVAL PRIOR TO DELIVERY AND INSTALLATION.
- U. SPREAD APPROVED MULCH UNIFORMLY OVER BEDS, USING CARE NOT TO DAMAGE PLANTS. AFTER PLACEMENT OF MULCH, FINISHED GRADE IN THE BED SHOULD BE A MINIMUM OF TWO INCHES BELOW EDGE OF CURB, PLANTER, OR WALK, UNLESS OTHERWISE SPECIFIED.
- V. THE CONTRACTOR SHALL MAINTAIN AT THE JOB SITE A SEPARATE SET OF PRINTS OF THE PROJECT FOR THE PURPOSE OF RECORDING "AS-BUILT" CHANGES AND DIAGRAMS OF THOSE PARTS OF THE WORK WHERE ACTUAL CONSTRUCTION DIFFERS FROM PLANS OR APPROVED SHOP DRAWINGS.

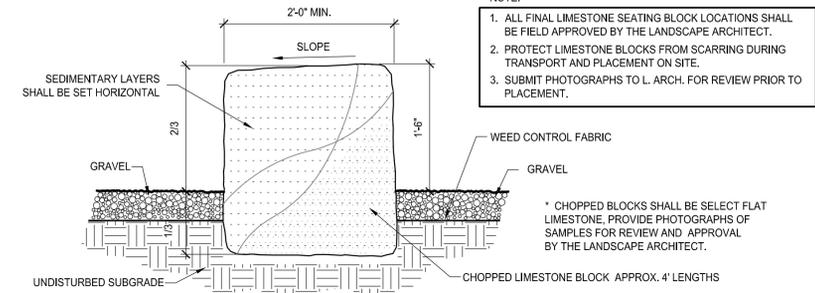

1 DETAIL: STONE SEATING BLOCKS
SCALE - 1/2"=1'

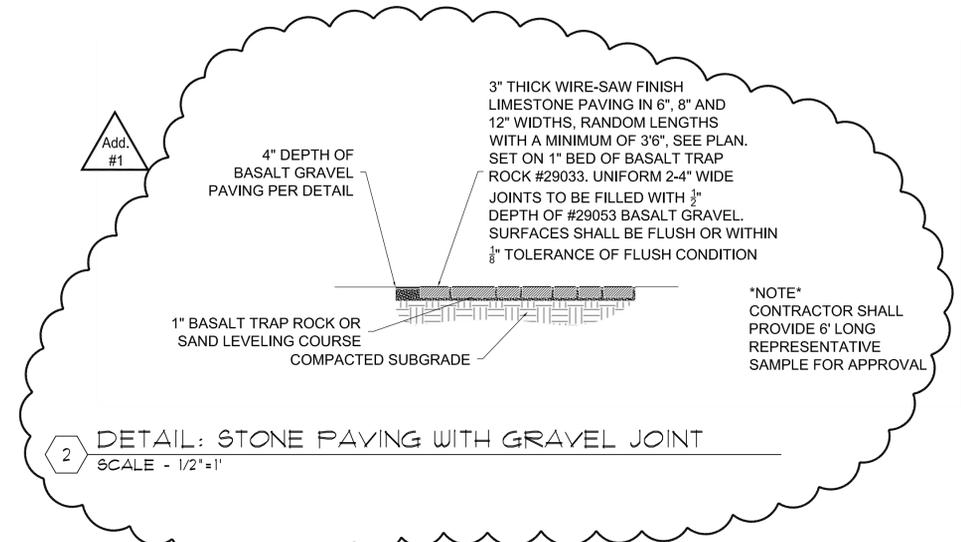

2 DETAIL: STONE PAVING WITH GRAVEL JOINT
SCALE - 1/2"=1'



Revision	Date

Submitted	Date
ADDENDUM #1	11/07/14

Job No.	Project Number
Date	2014-10-17
Checked by	LCC
Scale	SCALE VARIES

LANDSCAPE ORDINANCE

ELECTIVE REQUIREMENTS - 70 points required

Tree Preservation - 40 points, maximum	Qty.	Points
4 to 6 inch trees	3 points each	-
6 to 12 inch trees	4 points each	6
12 to 18 inch trees	6 points each	9
18 inch trees and larger	8 points each	8
		24
		54
		64

Inside Streetyard:
full credit up to 30 points
1/2 credit for total above 30 points

Outside Streetyard:
1/2 credit up to a maximum of 15 points

Total Points: Tree Preservation (40 Points, max.)

Parking Lot Shading	Points
Percent Shaded	
25%	20
35%	25
50%	35 ✓

Total Points: Parking Lot Shading 35 ✓
Screening of Surface Parking - 25 points
Street Trees - 25 Points
Understory Preservation or Restoration - 15 Pnts.
Infill or Retrofit Use Pattern - 25 pnts.
Total Points - Elective Criteria 75 ✓


Parking-lot Shading Calculations		2/21/2014
Project		
Total Parking-lot Area=	19,930.00 sf	
Shade Coverage Required=	25%	
Shade Coverage Provided=	4,982.50 sf	
Key	# of Trees	Shade Value
See Plan Large trees		
A	0	1200 @ 100%
B	13	1200 @ 75%
C	0	1200 @ 50%
Medium/Large trees		
D	0	875 @ 100%
E	0	875 @ 75%
F	0	875 @ 50%
Medium trees		
G	0	550 @ 100%
H	0	550 @ 75%
I	0	550 @ 50%
Medium/Small trees		
J	0	275 @ 100%
K	0	275 @ 75%
L	0	275 @ 50%
Total Shade Coverage Provided=	11,700.00 sf	
Total Shade Coverage Required=	58,711 sf	
100% shade value for existing trees meeting RPZ criteria		
75% shade value for trees in islands or peninsulas		
50% shade value for trees within 12' of a parking surface		

Tree Schedule


SYMB	QTY	Common Name	Botanical Name	Container	Size / Spacing / Comments
TREES					
BUO	1	Burr Oak	<i>Quercus macrocarpa</i>	36" box	16'-18" ht, 9'-12" sp., 5" cal., 5'-6' clr. trunk
BC	4	Bald Cypress	<i>Taxodium distichum</i>	30 gal. or 24" box	12'-14" ht, 5'-7" sp., 3"-4" cal., 4'-5' clr. trunk
SYC	12	Mexican Sycamore	<i>Platanus mexicana</i>	24" box	15'-17" ht, 6'-7" sp., 2"-2-1/2" cal., 4'-6' clr. trunk
RO	10	Shumard Red Oak	<i>Quercus shumardii</i>	24" box	12" min. ht, 5'-7" sp., 2-1/2" cal., 3' clr. trunk
CE	14	Cedar Elm	<i>Ulmus crassifolia</i>	24" box	13'-14" ht, 6'-7" sp., 3"-4" cal., 5' clr. trunk
LO	4	Live Oak	<i>Quercus virginiana</i>	24" box	8'-10" ht., 4'-5" sp., 2-1/2-3" cal.
MO	1	Monterrey Oak or Mexican White Oak	<i>Quercus polymorpha</i>	36" box	12'-14" ht., 6'-7" sp., 3-1/2"- 4-1/2" cal., 4'-5' clr. tr
CHO	4	Chinkapin Oak	<i>Quercus muehlenbergii</i>	20" box	9'-10" ht., 3-1/2" - 4-1/2" sp., 2" min. cal.
LYO	6	Lacey Oak	<i>Quercus laceyi</i>	45 gal. or 36" box	2.5'-3' cal., 14' ht., 6' spread
TLR	8	Thornless Retama	<i>Parkinsonia x 'Desert Museum'</i>	30" box	4'-5" cal., 15' ht., 8' spread (multi-trunk)
TML	2	Texas Mountain Laurel	<i>Sophora secundiflora</i>	30 gal.	5' ht., 4' spread, 1-1/2" cal.

KEY: TREES

LARGE TREES

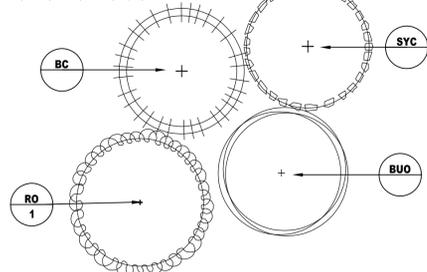

MEDIUM - LARGE TREES

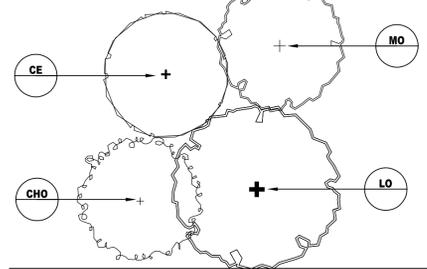

MEDIUM TREES



SMALL - MEDIUM TREES




SMALL TREES



PARKING LOT SHADE KEY:

- LARGE TREES**
A Existing Tree
B Island or Peninsula Tree within 12 feet of the edge of parking
C within 12 feet of the edge of parking
MEDIUM / LARGE TREES
D Existing Tree
E Island or Peninsula Tree within 12 feet of the edge of parking
F within 12 feet of the edge of parking
MEDIUM TREES
G Existing Tree
H Island or Peninsula Tree within 12 feet of the edge of parking
I within 12 feet of the edge of parking
MEDIUM / SMALL TREES
J Existing Tree
K Island or Peninsula Tree within 12 feet of the edge of parking
L within 12 feet of the edge of parking

FOR UNDERSTORY PLANTING, REFER TO SHEET LP1.1 AND SHEET LP1.2

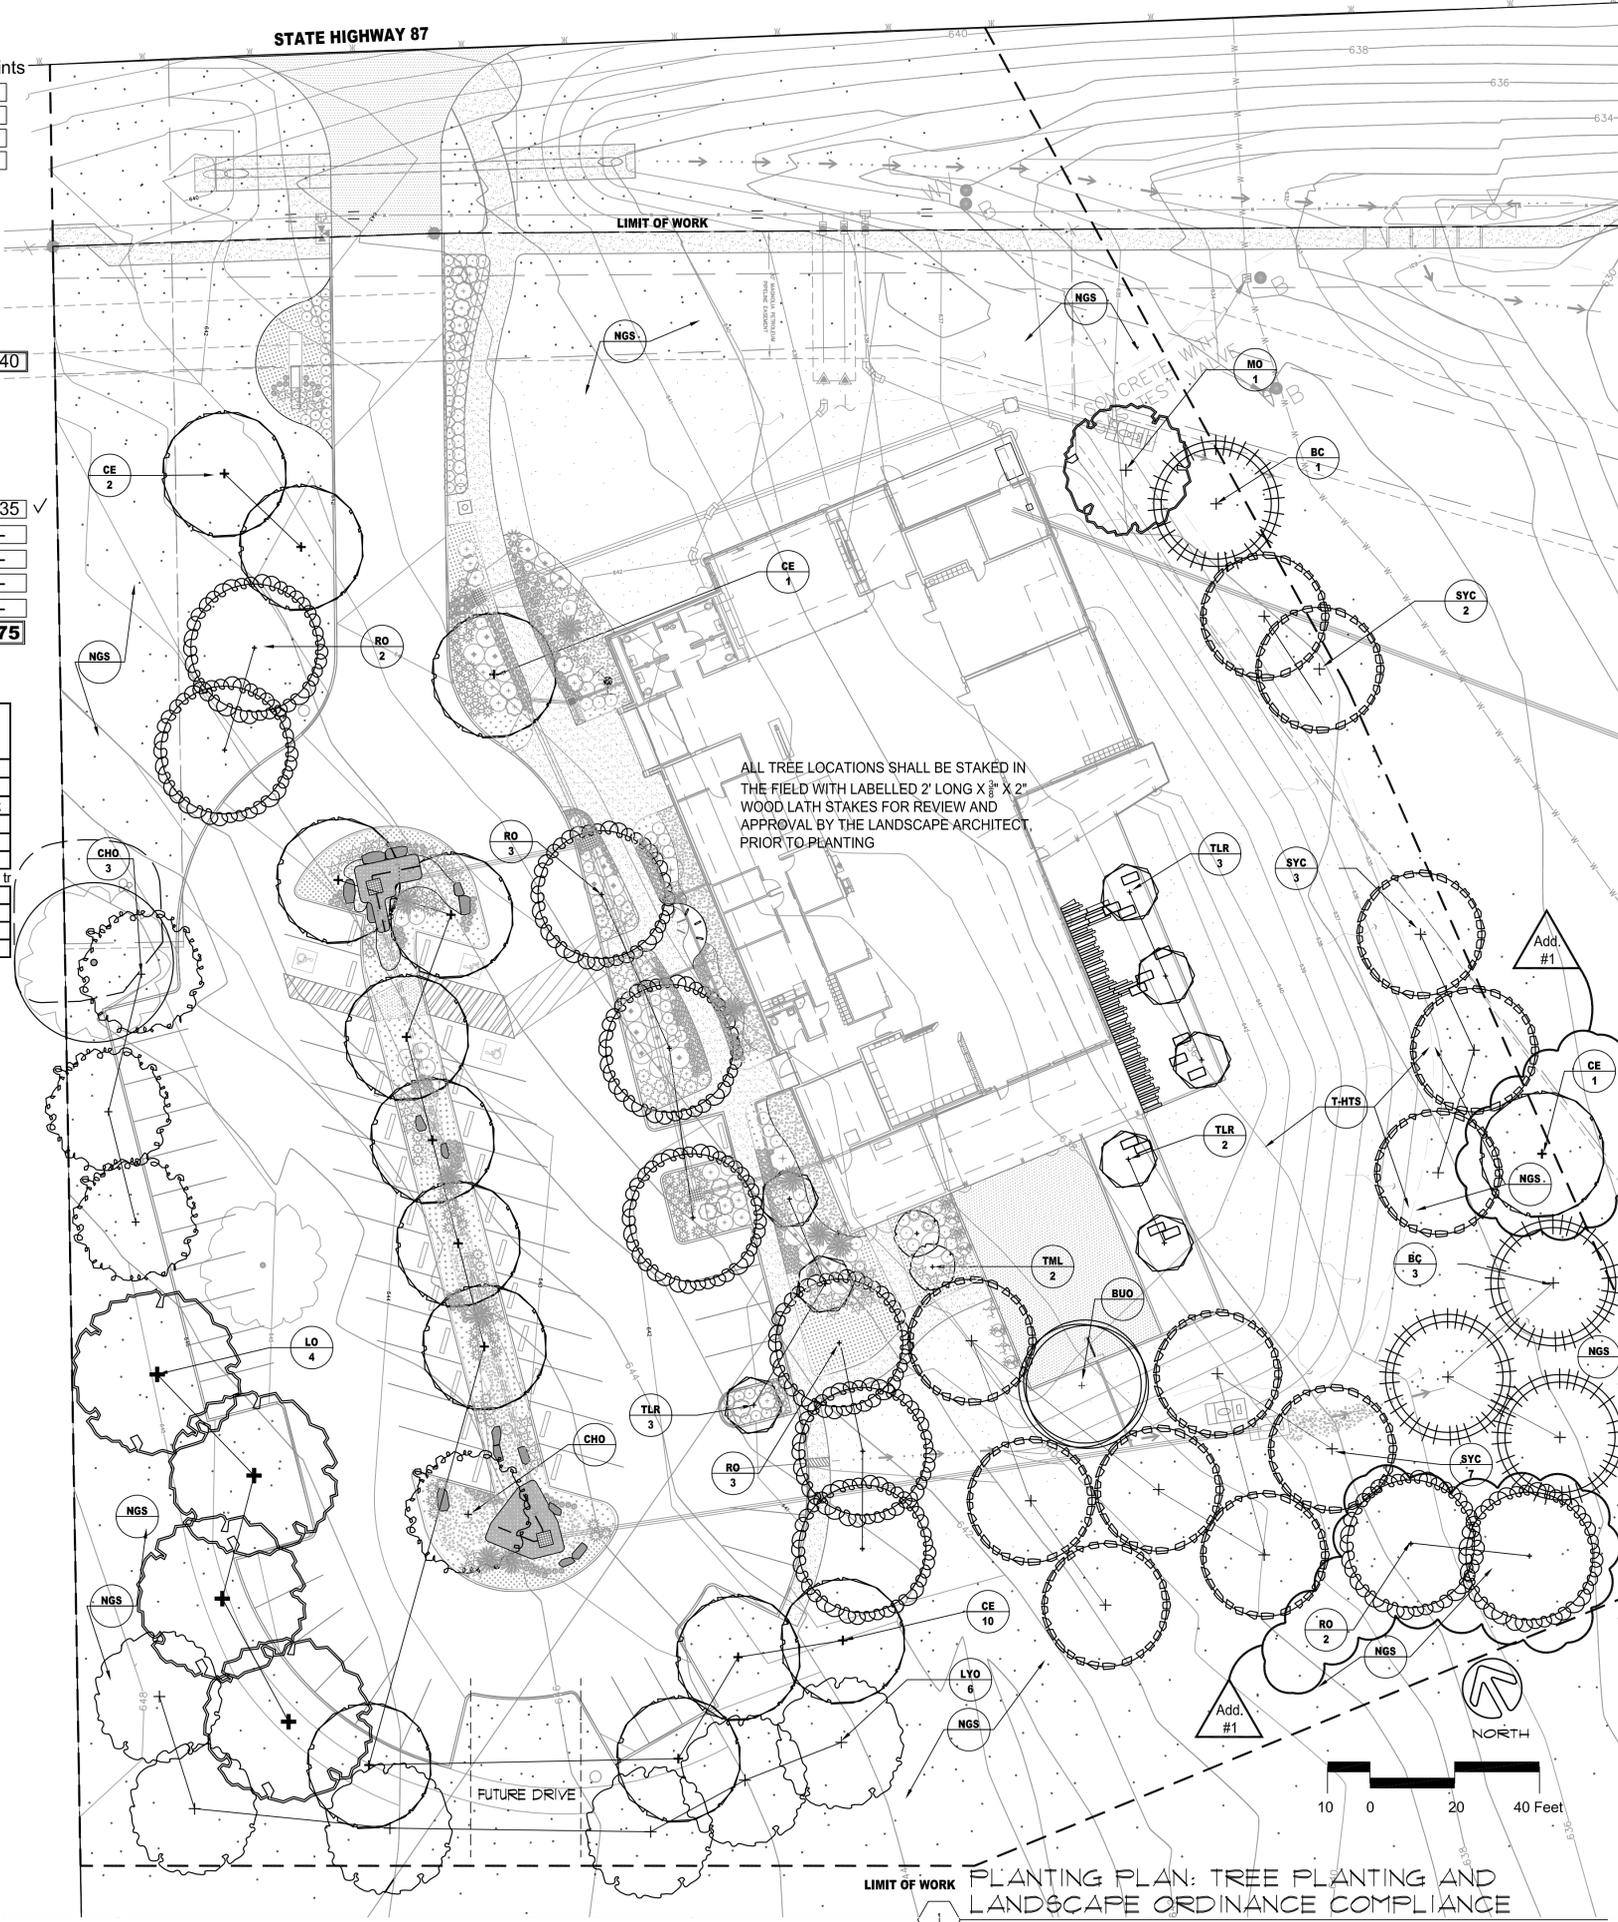

ALL TREE LOCATIONS SHALL BE STAKED IN THE FIELD WITH LABELLED 2" LONG X 3/8" X 2" WOOD LATH STAKES FOR REVIEW AND APPROVAL BY THE LANDSCAPE ARCHITECT PRIOR TO PLANTING

PLANTING PLAN: TREE PLANTING AND LANDSCAPE ORDINANCE COMPLIANCE
 SCALE - 1"=20'

LPA
 LANDSCAPE ARCHITECTS
 LAWRENCE C. CLARK
 210.899.1730
 l.clark@lpa.com
 210.899.1737
 w.ecolpa.com
 114 East Conillas Street
 San Antonio, Texas 78204

LAWRENCE C. CLARK
 LANDSCAPE ARCHITECT
 1211
 TX REGISTRATION NO. 1211
 2014-10-17
 DATE

Landscaping Architecture
 Urban Design
 Planning
 830 North Alamo Street
 San Antonio, Texas 78215
 210.692.0221
 www.landscape.org

BENDER WELLS DESIGN
 ARCHITECTURE
 1000 North Alamo Street
 San Antonio, Texas 78215
 210.692.0221
 www.benderwellsdesign.com

DISTRICT 2 BRANCH LIBRARY
 U.S. HWY 87, SAN ANTONIO, TEXAS 78222
 Developed for CITY OF SAN ANTONIO

This and other project documents and all items...
 Copyright © 2014

Date	
Revision	

Submitted	11/07/14
ADDENDUM #1	

Job No.	Project Number
Date	2014-10-17
Checked by	LCC
Scale	SCALE - 1"=20'

PLANTING PLAN

LP1.0